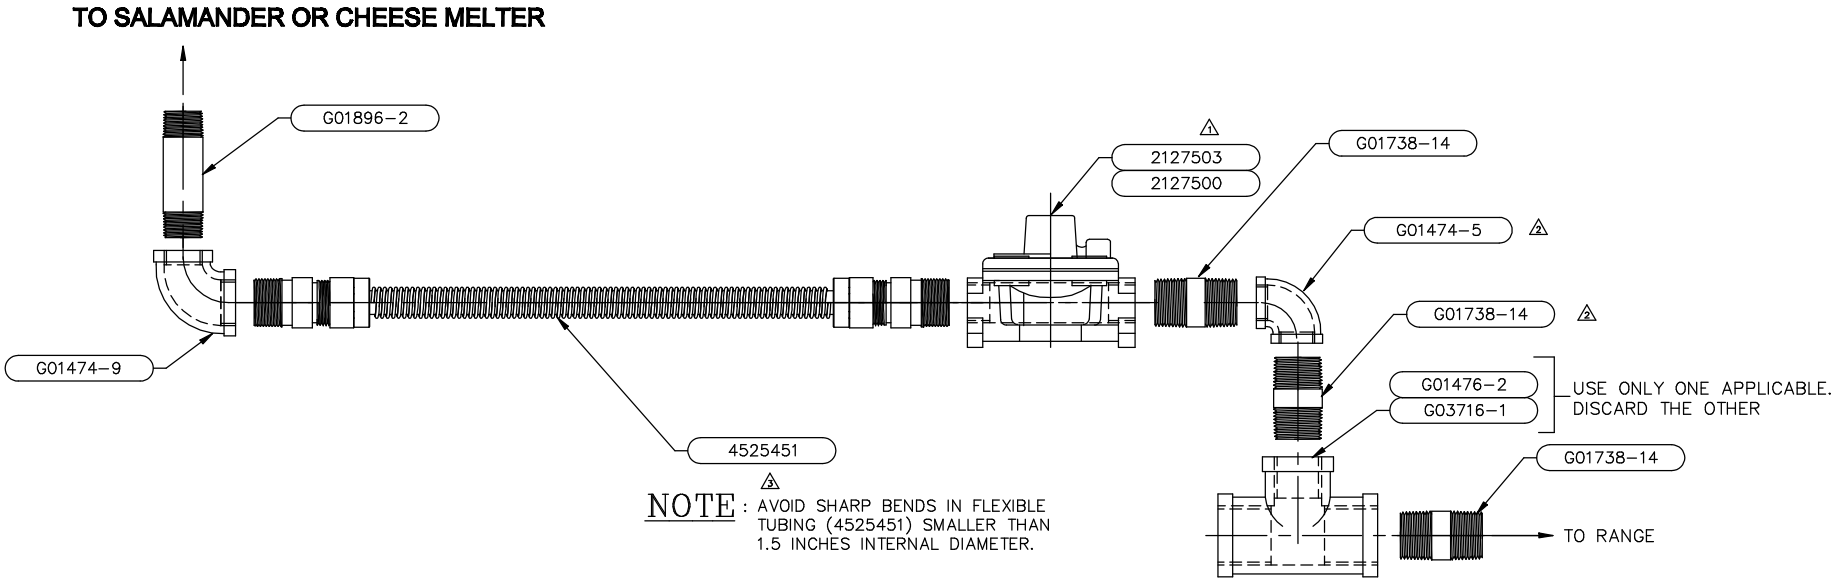

NOTE : AVOID SHARP BENDS IN FLEXIBLE TUBING (4525451) SMALLER THAN 1.5 INCHES INTERNAL DIAMETER.

	PART #	DESCRIPTION	QTY	FIN.	MODEL
3	4525451	72" FLEXIBLE S.S. TUBE ASSY	1	1	
2	G01738-14	NIPPLE 3/4"NPT x 2"	3	3	
	G01896-2	NIPPLE 1/2"NPT x 3 1/2"	1	1	
	G01474-9	90° REDUCING ELBOW 3/4"NPT x 1/2"NPT	1	1	
1	2127503	REGULATOR NAT.	1		
	2127500	REGULATOR PRO.		1	
	G03716-1	TEE 1"NPT x 3/4"NPT x 3/4"NPT	1	1	
	G01476-2	TEE 3/4"NPT x 3/4"NPT x 3/4"NPT	1	1	
OBS. 3	~~G01739-1~~	~~1/2"NPT UNION~~	~~1~~	~~1~~	
OBS. 3	~~G01477-3~~	~~CLOSE NIPPLE 1/2"NPT~~	~~1~~	~~1~~	
2	G01474-5	90° ELBOW 3/4" NPT	1	1	
OBS. 3	~~3013000~~	~~COMPRESSION FITTING 3/4" TUBE x 3/4" PIPE~~	~~2~~	~~2~~	
OBS. 3	~~3012900~~	~~TUBING 3/4" x 52"LG x .065WALL~~	~~1~~	~~1~~	
	3012997	RESTAURANT UNIVERSAL INTERCONNECT KIT (PRO)		*	
	3012998	RESTAURANT UNIVERSAL INTERCONNECT KIT (NAT)	*		

REV	DESCRIPTION	DR.	DATE	APPR.
3	ADDED 4525451 .DELETED G01477-3, G01896-2, G01739-1, 3013000, CHANGED NOTE.	A.V.	AUG.6/08	03158
2	G01474-5 WAS G01475-2 G01738-14 QTY 3 WAS 2	A.V.	MAR 5/08	02758
1	#2127503 WAS 2127502	A.V.	OCT.4/00	00/136

REVISIONS

TOLERANCES (EXCEPT AS NOTED) ±.031 ANG. ±2° — ALL DIMENSIONS ARE IN INCHES

DR: A.V. | APPR. | SCALE: NTS | DATE: SEP.8/99

TITLE: RESTAURANT UNIVERSAL INTER-CONNECT KIT

GARLAND
COMMERCIAL RANGES LIMITED
MISSISSAUGA, ONTARIO, CANADA

30129

SHT 3 OF 3

3